



QUOTATION  
FEDERAL SIGNAL CORPORATION  
Federal Warning Systems

Quotation No.: FWS **41415212**  
Reference quote no. on your order

Name City of Lake Elmo  
Co. Name Fire Chief Greg Malmquist  
Address 3510 Laverne Avenue N  
City, State, Zip Lake Elmo, MN 55042  
Phone No. 651-770-5006  
Fax No. GMalmquist@lakeelmo.org




Date 4/14/2015  
Reference \_\_\_\_\_

CUSTOMER COPY  
SALESPERSON COPY  
OFFICE COPY

Item No.	Qty.	Federal Model/Part No.	Description	Net Cost Each	Total Cost
1	2	2001-130	130 db Rotating Mechanical Siren		
2	2	DCFCTBDH	2-Way Digital DC Control/Battery Cabinet		
3			4 Chargers/Motorola CDM-750 Radio/		
4			Sensors/(2) 48VDC Contactors/NEMA		
5			Aluminum Cabinets		
6	2	OMNI	3 db Gain Omnidirectional Antenna		
7	2	AMB-P	Antenna Mounting Bracket - Pole		
8	1	MISC.	Shipping from Factory		
9	1	TOTAL	Equipment & Shipping		<b>\$27,930.00</b>
10					
11			<i>*Does not include installation on Class 2 Wood</i>		
12			<i>Pole with 4 Deep Cycle Batteries</i>		
13			<i>*Does not include Optimization of Commander</i>		
14			<i>Base at Woodbury PD</i>		
15					
16			<b>OPTIONS</b>		
17	2	2001TRBP	Transformer/Rectifier for AC/DC Operation	\$1,600.00	\$3,200.00
18	2	HTR4	4 Battery Warming Blankets Per Siren	\$310.00	\$620.00
19					
20	1	PVS220W-48	Photovoltaic Charging System - 220W Solar		\$3,225.00
21			Panels/Regulators to charge batteries.		
22			Aluminum Pole Mount Frame		

Prices are firm for 30 days from the date of quotation unless shown otherwise. Upon acceptance, prices are firm for \_\_\_\_\_ (days / months). This quotation is expressly subject to acceptance by Buyer of all Terms stated on the reverse side hereof, and any exception to or modification of such Terms shall not be binding on Seller unless expressly accepted in writing by an authorized agent or Officer of Seller. Any order submitted to Seller on the basis set forth above, in whole or in part, shall constitute an acceptance by Buyer of the Terms on this and the reverse side hereof. Any such order shall be subject to acceptance by Seller in its discretion. If the total price for the items set forth above exceeds \$50,000 then this quotation IS ONLY VALID if countersigned below by a Regional Manager of the Signal Division, Federal Signal Corporation.

F.O.B. University Park, IL  
EST. DEL. WT. \_\_\_\_\_  
DELIVERY 6 - 8 Weeks (ARO)  
TERMS NET 30 DAYS Equipment  
FREIGHT TERMS See Line Item Above

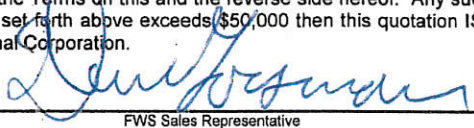BY:   
FWS Sales Representative  
ADDRESS: Federal Warning Systems, Inc.  
1708 3<sup>rd</sup> Ave. SE  
Rochester, MN 55904  
BY: \_\_\_\_\_  
Federal Signal / Countersigned  
TITLE: \_\_\_\_\_

Purchase order **MUST** be made out to:  
Federal Signal Corporation, Federal Warning Systems, 2645 Federal Signal Drive, University Park, IL 60424

# Ready Watt ELECTRIC

21269 Jarvis Street NW

Nowthen, MN 55330

Phone 763-241-4944

Fax 763-241-5245

www.readywattelectric.com

rschiller@readywattelectric.com

## Estimate

Date	Estimate #
7/28/2015	15-524

Name / Address	
City of Lake Elmo 3800 Laverne Avenue Lake Elmo, MN 55042 Attention: Chief Greg Malmquist	
	Project
	15-524 Siren Cinarron Park
Description	
<p>Install Cities 2001 DC Siren, controller, antenna on wood pole.</p> <p>Ready Watt Electric will supply and or install wood pole, batteries, electric material, electric permit, labor, bring power from water tower and test siren.</p> <p style="text-align: right;">TOTAL: \$8502.00</p> <p>To woodpecker proof siren pole add \$580.00</p> <p>To remove Siren at Club House and dispose of Add \$1966.00</p> <p>Price does not include Power Co charges, dirt restoration, snow removal or un-augarable soil conditions if any.</p> <p>If there are any additional questions please call me. Bob Schiller 612-282-4840 Over 40 years of Civil Defense Siren experience, installation, maintenance, and consulting.</p> <p>We look forward in doing business with you, Bob Schiller, Siren Coordinator 612-282-4840</p>	

### ACCEPTANCE OF PROPSAL

(must be signed and returned for work to begin)

NOTE: This proposal may be withdrawn by Ready Watt Electric if not accepted with in 15 days.

The above prices, specifications and conditions are satisfactory and are herby accepted. You are authorized to do the work as specified. Payment will be made as outlined above.

Signature \_\_\_\_\_

# Ready Watt ELECTRIC

21269 Jarvis Street NW  
Nowthen, MN 55330  
Phone 763-241-4944  
Fax 763-241-5245  
www.readywattelectric.com  
RSchiller@readywattelectric.com

## Estimate

Date	Estimate #
7/28/2015	15-532

Name / Address	
City of Lake Elmo 3800 Laverne Avenue Lake Elmo, MN 55042 Attention: Tom Bouthilet	
Project	
15-532 Julep Ave N Siren Install	
Description	
<p>Install Cities FWS 2001 DC Siren on wood pole for over head power.</p> <p>Ready Watt Electric will supply and or install wood pole, batteries, labor, electric material, electric permit ect.</p> <p>To woodpecker proof pole add \$580.00</p> <p>Price does not include Power Company charges, snow removal, dirt restoration, un-augarable soil conditions if any.</p> <p>If there are any additional questions please call me. Bob Schiller 612-282-4840 Over 40 years of Civil Defense Siren experience, installation, maintenance, and consulting.</p>	
We look forward in doing business with you, Bob Schiller, Siren Coordinator 612-282-4840	<b>Total</b> \$7,651.00

### ACCEPTANCE OF PROPSAL


(must be signed and returned for work to begin)

NOTE: This proposal may be withdrawn by Ready Watt Electric if not accepted with in 15 days.

The above prices, specifications and conditions are satisfactory and are herby accepted. You are authorized to do the work as specified. Payment will be made as outlined above.

Signature \_\_\_\_\_



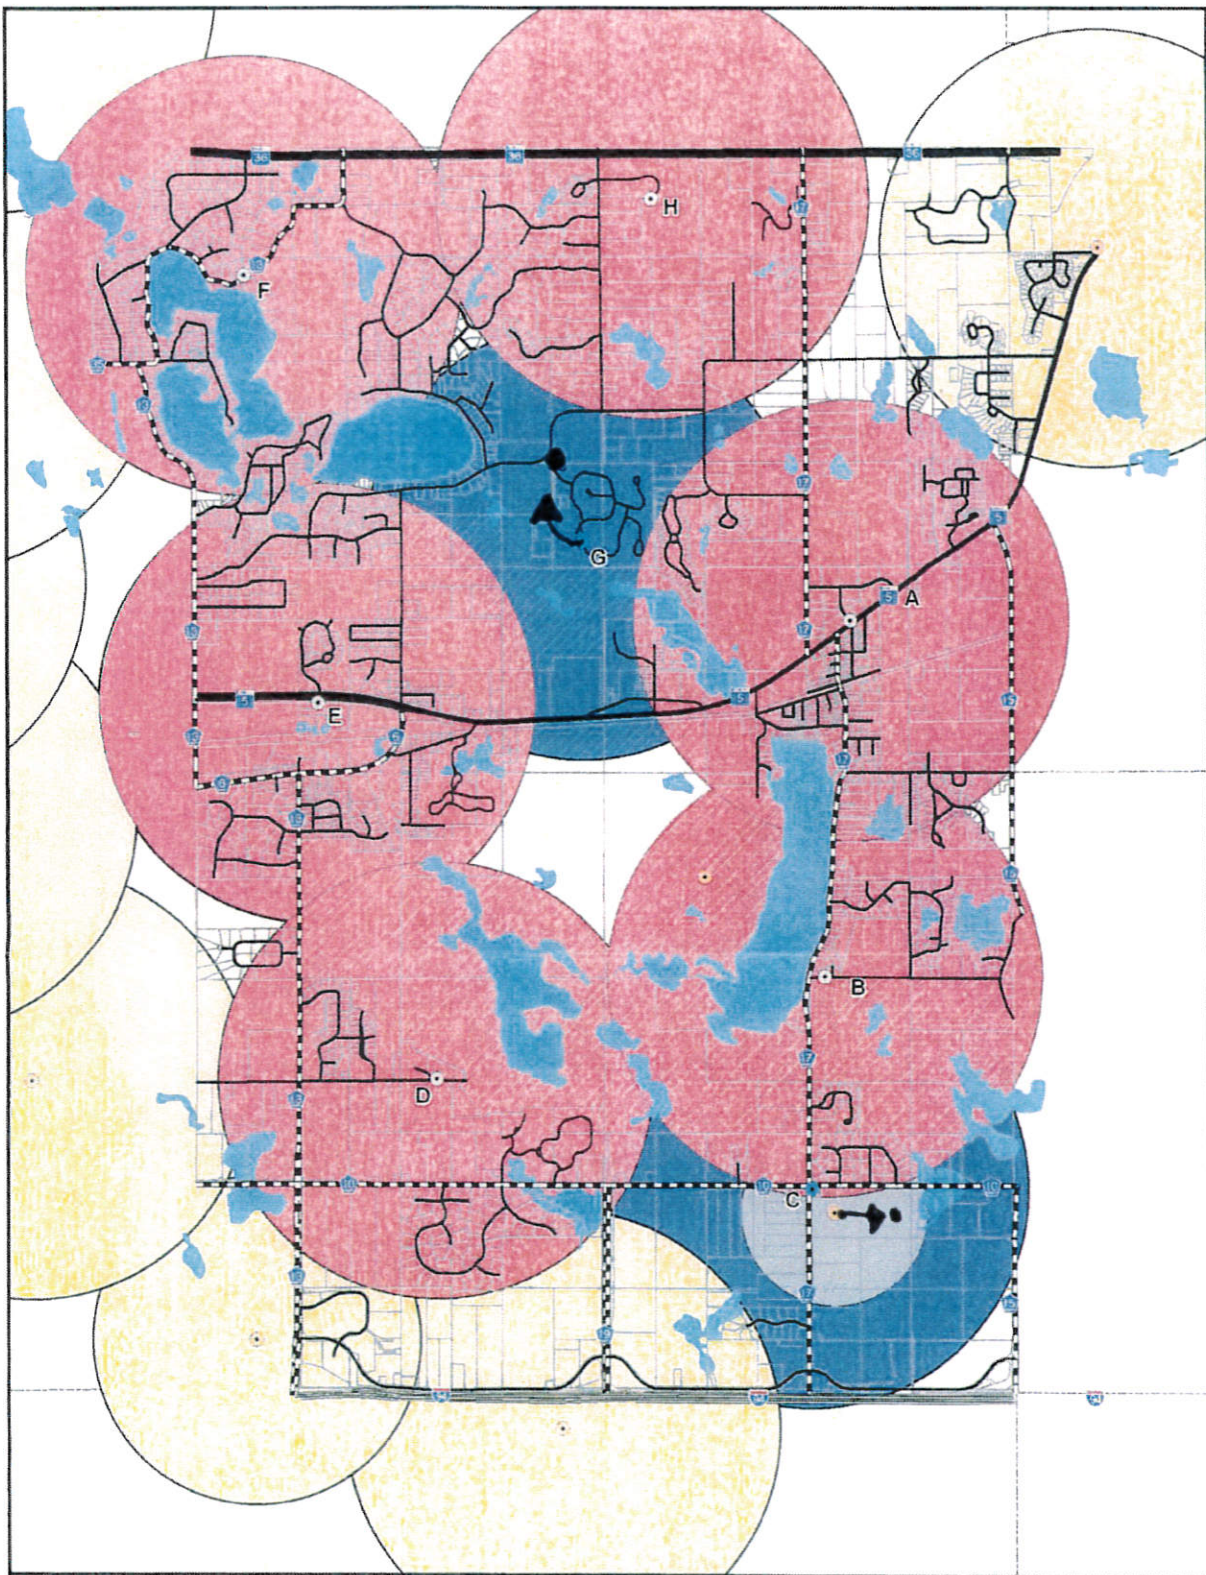

#### Legend

AS-BUILT CD SIREN LOCATION


#### CD SIREN LOCATIONS

- PROPOSED
- EXISTING
- LAKE ELMO PARKS

#### CD SIREN RANGE

- EXISTING IN LAKE ELMO
- EXISTING IN OTHER CITIES
- PROPOSED FOR LAKE ELMO
- TO BE REMOVED

## CIVIL DEFENSE SIREN PROJECT

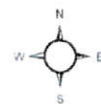

JUNE 11, 2007

**TKDA**

ENGINEERS • ARCHITECTS • PLANNERS