

To: Ken Roberts, City of Lake Elmo Planning Director

From: Lucius Jonett, Wenck Landscape Architect

May 7, 2019 Date:

Subject: City of Lake Elmo Landscape Plan Review

Springs at Lake Elmo, Review #1

Submittals

Tree Preservation Plan, dated April 12, 2019, received April 12, 2019.

Landscape Plans, dated April 12, 2019, received April 12, 2019.

Location: North of Hudson Boulevard North, West of Keats Avenue North in Lake Elmo, MN

Land Use Category: Rural Development Transitional being rezoned to Urban High Density Planned Unit Development

Surrounding Land Use Concerns:

The property to the north (Bentley Village) is Urban Medium Density Residential and is less intensive land use than the proposed Urban High Density Residential. Screening is required on the north boundary.

The property's use to the west (Rural Development Transitional) is unknown at the moment and east (Commercial) is a zone that is more intensive land use than this proposed Urban High Density Residential. Screening is not required on the east or west boundaries. To the south is Interstate 94 where screening is suggested to help with noise abatement.

Special landscape provisions in addition to the zoning code:

None.



Tree Preservation:

A. A tree preservation plan has been submitted that does meet all requirements.

	Entire Site	
Total Caliper Inches of Significant Trees On-Site:	1050	Cal Inches
Common Trees	489	
Conifer/Evergreen Trees	303	
Hardwood Trees	258	
Nuisance Trees	0	
Significant Inches Removed On-Site	1050	Cal Inches
Common Trees	489	
Conifer/Evergreen Trees	303	
Hardwood Trees	258	
Nuisance Trees	0	
30% Tree Removal Limits (Cal. Inches)	Allowed	Proposed
Subtract Common Tree Removals	146.7	489
Subtract Conifer/Evergreen Tree Removals	90.9	303
Subtract Hardwood Tree Removals	77.4	258
Removals in excess of 30% allowances		
Removals in excess of 30% allowances	142.0	Cal Inches
Common Removals in Excess of 30% Allowance	342.3	
Conifer Removals in Excess of 30% Allowance	212.1	
Hardwood Removals in Excess of 30% Allowance	180.6	
Common Tree Replacement Needed (1/4 the dia inches removed)	85.6	Cal Inches
Conifer Tree Replacement Needed (1/2 the dia inches removed)	106.1	Cal Inches
Hardwood Tree Replacement Needed (1/2 the dia inches removed)	90.3	Cal Inches
Common Tree Replacement Required @ 3" per Tree	29	# Trees
Conifer Tree Replacement Required @ 3" per 6' Tall Tree	36	# Trees
Hardwood Tree Replacement Required @ 3" per Tree	31	# Trees

- B. There are 37 specimen trees identified in the tree inventory. The following tree ID numbers are defined as specimen, 3501-3534, 3557, 3561, and 3563. All specimen trees are proposed for removal.
- C. Tree replacement is required because more than thirty (30) percent of the diameter inches of significant trees surveyed will be removed.
- D. Tree replacement calculations does follow the required procedure.
- E. This project is residential development; therefore, mitigation replacement trees shall be in addition to landscape required tree counts.



Landscape Requirements:

The preliminary landscape plans do not meet the code required number of trees. The preliminary plans show fewer than the code required tree quantities.

Total Trees to Date		184	
-			
Required Number of Trees	233		
gation reco	30		
Required Mitigation Trees	96		
/50 = Required Frontage Strip Trees	26		Trees
Perimeter Parking Lot Frontage Length*	1286		Lineal Feet
			T 1
/10 = Required Parking Lot Trees	4		Trees
Interior Parking Lot Spaces*	36		Spaces
*5 = Required Development Trees	85		Trees
Development or Disturbed Area	17		Acres
Development or Disturbed Area	-		SF
750 rece - Required Frontage frees	22		11003
/50 Feet = Required Frontage Trees	22		Trees
Total Linear Feet	1100		Lineal Feet
Lake Shore Stream Frontage	0		Lineal Feet Lineal Feet
Street frontage	1100		Lineal Feet
	(Code Required)	Proposed	I
	Master Plan	Master Plan	

^{*} Residential development - mitigation replacement trees are in addition to landscape required tree counts.

- 1. A minimum one (1) tree is proposed for every fifty (50) feet of street frontage.
- 2. A minimum of five (5) trees are proposed to be planted for every one (1) acre of land that is developed or disturbed by development activity.

The landscape plans do meet the minimum compositions of required trees:

- At least 25% of the required number of trees shall be deciduous shade trees
- At least 25% of the required number of trees shall be coniferous trees
- Up to 15% of the required number of trees may be ornamental tree

Master Plan	Qty	% Composition	
Deciduous Shade Trees	125	74%	>25% required
Coniferous Trees	44	26%	>25% required
Ornamental Trees	15	9%	<15% required

Tree Count 169

- A. A landscape plan has been submitted that does not include all requirements.
 - 1. The landscape plan does not include required City standard notes and details.

Ken Roberts

Planning Director City of Lake Elmo May 7, 2019



- B. The landscape plan does not meet the landscape layout requirements.
 - No utility conflicts; Prefer that the trunk of trees shall be 10 feet from the nearest utility, including water and sewer service stubs to each lot.
- C. Interior Parking Lot Landscaping The development does include several interior parking lots. Only one meets the threshold of 30 parking spaces and does not meet the following landscape requirements.
 - 1. At least 5% of the interior area of parking lots with more than 30 parking spaces is devoted to landscape planting areas. The parking lot is measured at approximatively 8,650 square feet and a planting bed measuring approximately 0 square feet separates the parking lot from the circle drive/drop-off area. The planting area is approximately 0% of the interior of the parking lot area.
 - 2. The planting area includes 1 shade tree and does not satisfy the minimum required 4 tree planted to meet the requirements for this interior parking lot.
- D. Perimeter Parking Lot Landscaping The development does include perimeter parking lots and does not meet the following landscape requirements.
 - 1. Alongside and rear property lines abutting residential properties or districts, screening shall be provided, consisting of either a masonry wall, fence or berm in combination with landscape material that forms a screen a minimum of four (4) feet in height, a maximum of six (6) feet in height, and not less than ninety percent (90%) opaque on a year-round basis. Landscape material shall include trees, planted at a minimum of one deciduous or coniferous tree per forty (40) linear feet along the property line.
- E. Screening The landscape plan does not meet screening requirements.

Screening is required by City code. Screening shall be used to provide visual and noise separation of intensive uses from less intensive uses. Where screening is required in the City Code between uses or districts, it shall consist of either a masonry wall (chain link will not suffice) or fence in combination with landscape material that forms a screen at least six (6) feet in height, and not less than ninety percent (90%) opaque on a year-round basis. Landscape material shall include trees, planted at a minimum of one deciduous or coniferous tree per forty (40) linear feet along the property line. Additional landscape material such as shade trees or trellises may be required to partially screen views from above.

A single, straight row of evergreen trees is inadequate for screening. Vegetative screening should consist of more than one row of evergreen trees and include a row of other trees or native shrubs in front of the evergreens to soften the "development wall" effect.

Ken Roberts

Planning Director City of Lake Elmo May 7, 2019



Findings:

- 1. Tree calculations for mitigation and landscape requirements are based on 3" DBH trees. This diameter exceeds the minimum size required and provides fewer trees at a larger diameter.
- 2. Tree replacement calculations do not follow the required procedure. We are not able to follow the math of how the common, conifer, and nuisance species were tabulated. Please provide tabulations.
- 3. Preliminary landscape sheets do not include required City standard notes and details. Update details using City standard notes and details.
- 4. There are some landscape conflicts with utility lines. Please refer to attached document for problem areas. Please correct tree spacing so the trunk of trees shall be 10 feet from the nearest utility, including water and sewer service stubs to each lot.
- 5. The preliminary landscape plans do not calculate interior parking lot and perimeter parking lot tree plantings. Please refer to attached document for identified issues. Please update landscape plan to provide the required plantings.
- 6. The north side of the property will need to satisfy both screening and perimeter parking lot requirements.


Recommendation:

It is recommended that a condition of approval include submitting a revised landscape plan addressing findings 2-6 listed above.

Sincerely,

Lucius Jonett, PLA (MN) Wenck Associates, Inc.

City of Lake Elmo Municipal Landscape Architect

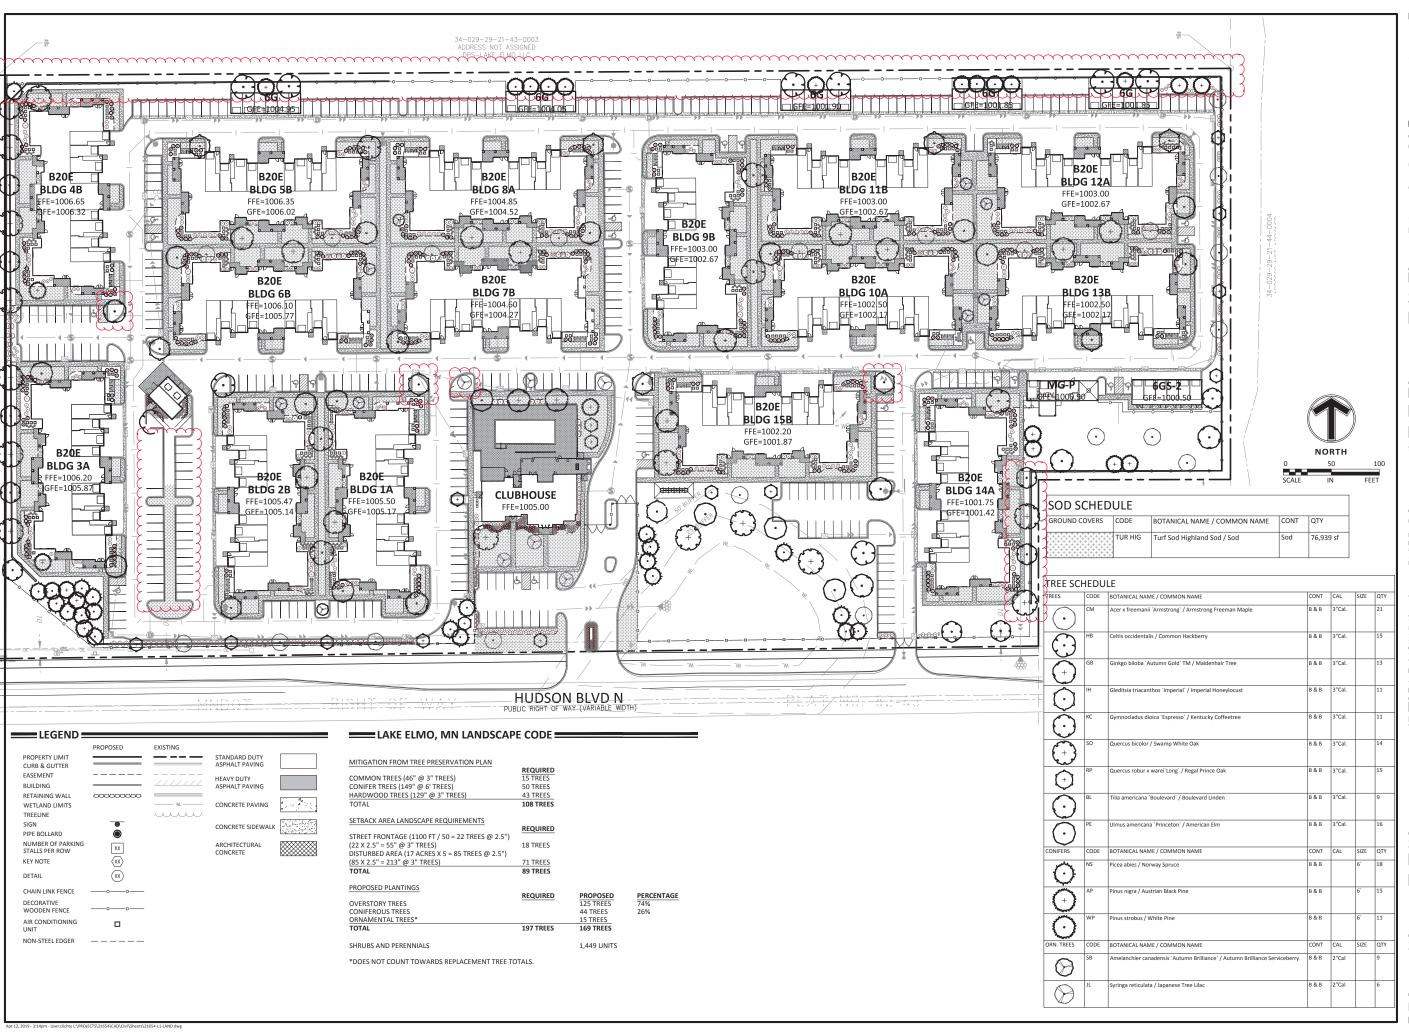



Engineering | Surveying | Plenning | Envir

Client **CONTINENTAL 483 FUND LLC**

W134 N8675 EXECUTIVE PARKWAY MENOMONEE FALLS, WI 53051

Project **SPRINGS AT LAKE ELMO**

Location LAKE ELMO, **MINNESOTA**

9955 HUDSON BOULEVARD NORTH

Certification

I hereby certify that this survey, plan or report we prepared by me or under my direct supervision and that I am a duly Licensed LANDSCAPE ARCHITECT under the laws of the State of Minnesota.

William L Delay M. Registration to 1052 Date: 4/12/2019
This companies is not valid unless wet signed in this survey of the surv

Summary

Designed: EAV Approved: EAV Book / Page: Phase: PRELIMINARY Initial Issue: 4/12/201

Revision History

No.Date By Submittal / Revision

Sheet Title LANDSCAPE PLAN

Sheet No. Revision

L1.01

Project No.

21654